




Copyright:MASDAR. All rights reserved. Except as permitted by the Copyrights Designs and Patents Act 1988 no part of this document may be reproduced, stored, transmitted or distributed in any form or by any means, whether electronic, mechanical, by photocopy, recording or otherwise, without the prior written permission of a director. Except where otherwise expressly agreed in writing MASDAR shall have no responsibility or liability for any loss (direct, consequential or otherwise) which may arise from reliance on or use of this document or the information contained in it.

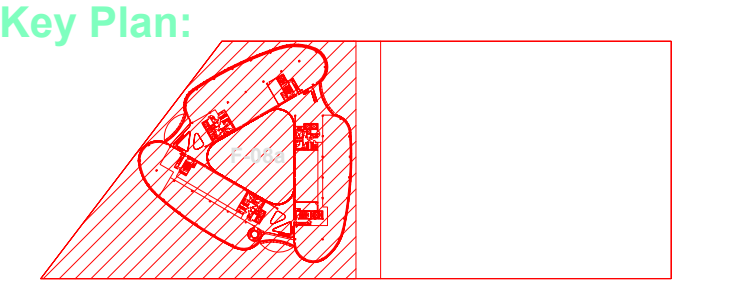

GENERAL NOTES:
A ALL DIMENSIONS ARE IN MM UNO.
B ALL LEVELS ARE IN METERS REFERRING TO NEW ABU DHABI MUNICIPALITY DATUM UNO.
C DO NOT SCALE FROM THIS DRAWING. ONLY WRITTEN DIMENSIONS SHALL BE FOLLOWED.

AB	AS-BUILT	CJ	22-12-18
Rev	Description	Drawn	Chk'd

Revisions

Project Title
IRENA WORKPLACE, MASDAR H.Q. ON PLOT NO. F-08a

Drawing Title	Design Drawing
ELECTRICAL LIGHTING LAYOUT MEETING ROOM-LEVEL 3	

Drawn:-	Checked:- DT	Approved:- SO	Sheet:-
Scale (A1)	Date:- 22-12-18	Status:- AB	Internal Rev:- AB
Drawing Number			
MAHQ-01-JLW-EL-AB-3209			

REV. AB
For Municipality Approval

1507mmx120mm INDIRECT/DIRECT LUMINAIRE WITH MPO MICRO PYRAMIDAL OPTIC C/W DIGITAL DIMMABLE DALI CONTROL GEAR. 1x49W T16 LAMP
PD PRESENCE DETECTOR
LED STRIP COVE LIGHT
NEW LED 20/20 LIGHT

AS BUILT